




PRECISION
surveyors

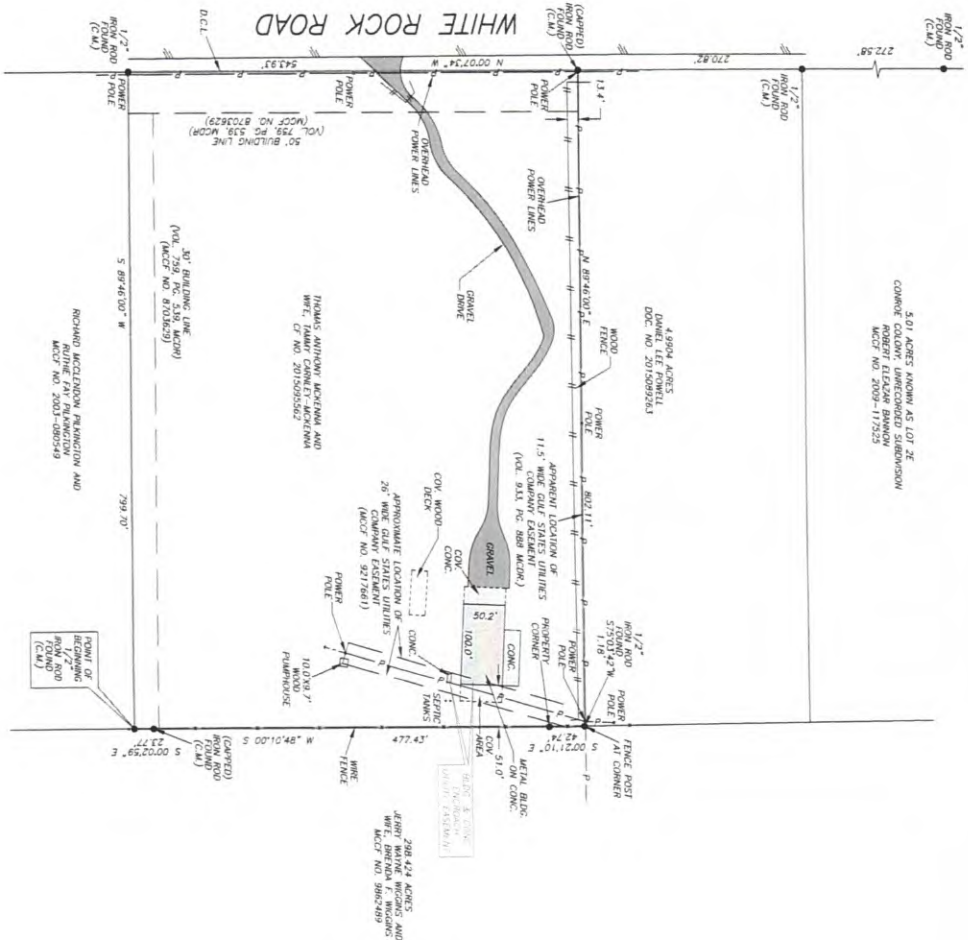

SCALE: 1" = 150'

ADDRESS: 10699 WHITE ROCK ROAD
CONROE, TEXAS 77306
ORDERED BY: THOMAS A. MCKENNA AND
TAMMY C. MCKENNA

10.003 ACRES
SITUATED IN THE
H.S. WILLIAMSON SURVEY, ABSTRACT NO. 635
IN MONTGOMERY COUNTY, TEXAS
(SEE ATTACHED METES AND BOUNDS DESCRIPTION)



NOTE: THIS SURVEY WAS PROVIDED WITHOUT A TITLE COMMITMENT.
OTHER EASEMENTS AND/OR ENCLAVING LINES HAVE NOT BEEN TRACED.

THIS PROPERTY DOES NOT LIE WITHIN THE
100 YEAR FLOOD PLAIN AS PER FIRM
NO. 15028, DATED 02/25/09,
MONTGOMERY COUNTY, TEXAS.
ZONE X. THE ONLY DATA EXAMINATION OF MAPS
AND RECORDS OF FIRM MAPS PRESENT EXACT
DETERMINATION WITHOUT DETAIL FIELD STUDY.

A SUBSURFACE INVESTIGATION
WAS BEYOND THE SCOPE OF THIS SURVEY.

D.C.L. - CONSTRUCTION, CONTROL LINE
RECORD DRAWING: ACCT NO. 2006-143178
I HEREBY CERTIFY THAT THIS SURVEY WAS MADE
ON THE GROUND, THAT THIS PLAT CORRECTLY
REPRESENTS THE ACTS, TENDS, AND THE NO
EXERCISEMENTS APPEARING ON THE GROUND
CERTIFIED FOR THIS TRANSACTION ONLY.

TERRANCE MISH
PRECISION LAND SURVEYOR
NO. 4981
JULY 01, 2016 (EXPIRING)



(JULIAN DT: 087 AM)

DS
BAW

DS
KRW